


DRAWING NUMBER
392.01
CANTOR, FITZGERALD
105P-6


DRAWING NUMBER

DRAWING NUMBER

DRAWING NUMBER

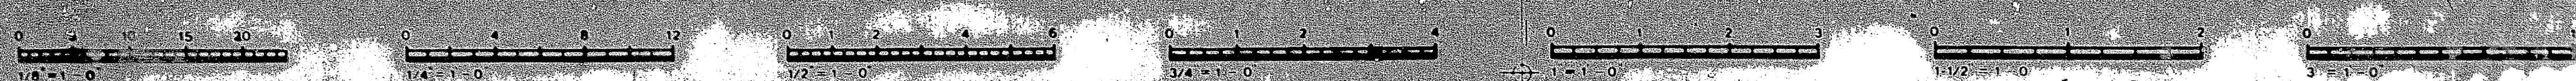


IF THIS DRAWING IS NOT 24" X 36" IT IS
A REDUCED PRINT SCALE ACCORDINGLY

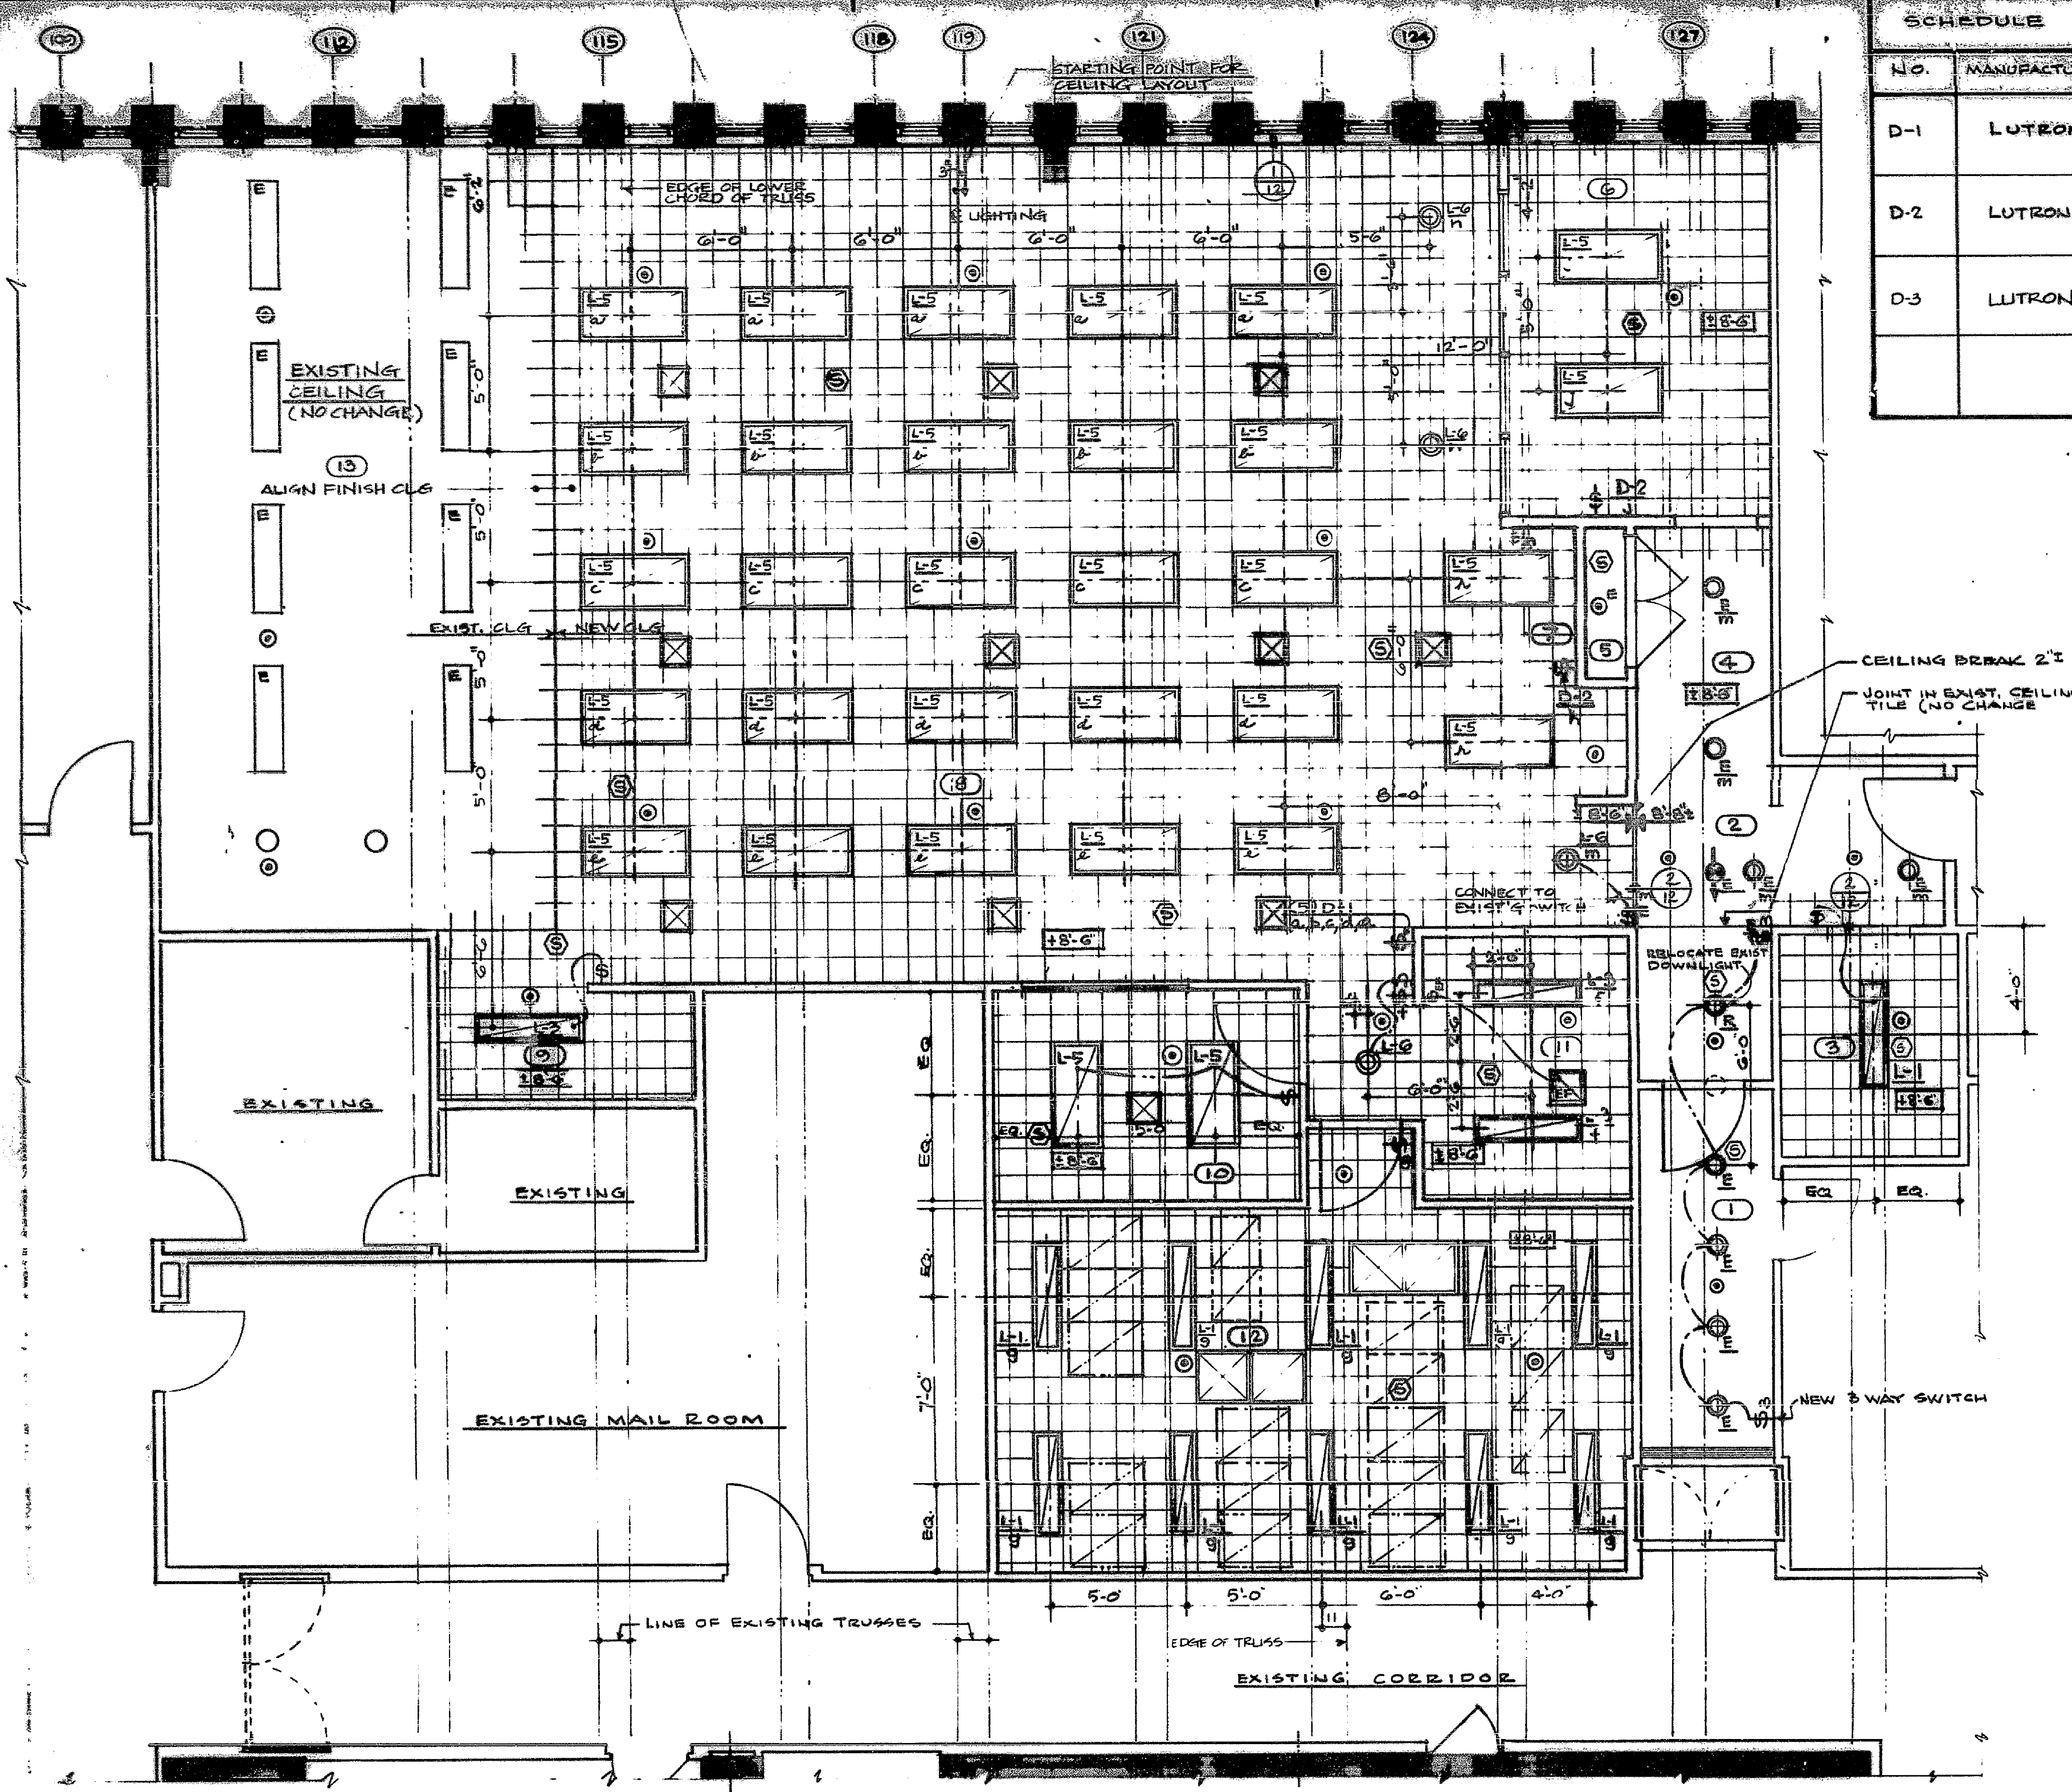

SCHEDULE OF DIMMING CONTROLS			
NO.	MANUFACTURER	TYPE & MODEL NUMBER	REMARKS
D-1	LUTRON	NOVA FLUORESCENT NF 20-277	MAXIMUM NO. OF LAMPS PER CONTROL = 24
D-2	LUTRON	NOVA FLUORESCENT NF 10-277	MAXIMUM NUMBER OF LAMPS PER CONTROL = 12
D-3	LUTRON	NOVA INCANDESCENT IN-600	MAXIMUM LOAD 600W (NO CHANGE)

SYMBOL LEGEND	
	SPACE NO. SYMBOL
	EXISTING LIGHTING FIXTURE TO BE REMOVED OR RELOCATED
	DEMOLITION, REMOVAL PLAN DWG NO. 105P-4
	NEW OR RELOCATED LIGHTING FIXTURE - SEE LIGHTING SCHEDULE THIS SHEET
	E = EXISTING R = RELOCATED
	EXISTING DOUBLE SIDED DIRECTIONAL EXIT SIGN (NO CHANGE)
	CEILING HEIGHT ABOVE CONCRETE FLOOR SLAB (SEE NOTE A BELOW)
	SWITCH - LOWER CASE LETTER DENOTES FIXTURES CONTROLLED E = EXISTING
	DIMMER SWITCH - SEE SCHEDULE THIS SHEET LOWER CASE LETTER DENOTES FIXTURES CONTROLLED
	FLUSH SPRINKLER HEAD - SEE ENGINEERING DRAWING 105P-5P1 FOR PIPING LAYOUT & ELEVATION
	HVAC SUPPLY DIFFUSER - SEE MECHANICAL ENGINEERING DRAWINGS
	HVAC RETURN AIR GRILLE - SEE MECHANICAL ENGINEERING DRAWINGS
	CEILING MOUNTED SMOKE DETECTOR - SEE ELECTRICAL ENGINEERING DRAWING 105P-2
	INDICATES CEILING BREAK ELEVATION SHOWN IS ABOVE FINISH FLOOR FOR EACH SIDE OF BREAK
	EXISTING LIGHT FIXTURES (NO CHANGE)

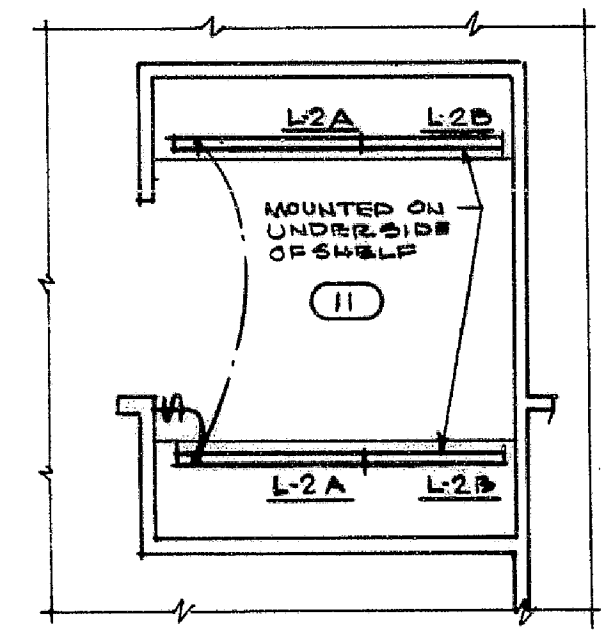


PLAN AT UPPER SHELF
SPACE NO. 11
C 1/4" = 1'-0"

NOTE "A"
ALIGN FINISH ACOUSTIC TILE CEILING WITH
EXISTING CEILING IN SPACE NO. 13.

SCHEDULE OF LIGHTING FIXTURES									
NO.	SYMBOL	MANUFACTURER & CATALOG NUMBER	DIMENSIONS	LAMP TYPE	TOTAL NO. REQD.	TOTAL REMOVED	NO. NEW	REMARKS	
L-1		EDISON PRICE VISIONAIRE'S RECESSED (2) LAMP PARABOLIC AIR HANDLING	L: 4'-0" W: 1'-0" H: 5 3/4"	(2) F40T12RS WARM WHITE	11	23	11	0	EXISTING AIR HANDLING FIXTURE
L2A		NATIONAL LIGHTING CO. #145 CE-25 120V	L: 4'-0" W: 3/4"	(1) F40T12RS WARM WHITE	2	0	0	2	INSTALLED BELOW SHELVING SPACE NO. 11
L2B		NATIONAL LIGHTING CO. #156 CE-25 120V FLUORESCENT STEP LIGHTS	L: 5'-0" H: 3/4"	(1) F40T12RS WARM WHITE	2	0	0	2	AIR HEAT EXCHANGE FIXTURE
L-3		NATIONAL LIGHTING CO. #145 CE-25 120V	L: 4'-0" W: 3/4"	(2) F40T12RS WARM WHITE	3	0	0	3	AIR HEAT EXCHANGE FIXTURE
L-4		NATIONAL LIGHTING CO. #145 CE-25 120V	L: 4'-0" W: 3/4"	(2) F40T12RS WARM WHITE	3	0	0	3	AIR HEAT EXCHANGE FIXTURE
L-5		NATIONAL LIGHTING CO. #145 CE-25 120V	L: 4'-0" W: 3/4"	(2) F40T12RS WARM WHITE	3	0	0	3	AIR HEAT EXCHANGE FIXTURE
L-6		CHIESI LIGHTING CO. #145 CE-25 120V	L: 4'-0" W: 3/4"	(2) F40T12RS WARM WHITE	3	0	0	3	AIR HEAT EXCHANGE FIXTURE
L-7		CHIESI LIGHTING CO. #145 CE-25 120V	L: 4'-0" W: 3/4"	(2) F40T12RS WARM WHITE	3	0	0	3	AIR HEAT EXCHANGE FIXTURE

- LIGHTING NOTES**
- THE CONTRACTOR SHALL VERIFY WITH THE ARCHITECT AND/OR ENGINEER THAT ALL LIGHTING EQUIPMENT MEETS ALL NATIONAL & LOCAL CODES AS APPLICABLE E.G. THERMAL PROTECTION & U.L. LABEL
 - THE CONTRACTOR & MANUFACTURER SHALL BE RESPONSIBLE FOR THE PROPER VENTILATION & TEMPERATURE CONDITIONS OF THE LIGHTING FIXTURES
 - THE CONTRACTOR SHALL SUBMIT FOR WRITTEN APPROVAL OF THE ARCHITECT, MANUFACTURER'S CATALOG SPECIFICATION SHEETS FOR ALL STANDARD CATALOG LIGHT FIXTURES PRIOR TO THE PURCHASE OF SAME.
 - ALL COMPONENT PARTS OF THE ARCHITECTURAL LIGHTING INSTALLATION SHALL BE PROVIDED BY THE GENERAL CONTRACTOR. COLORED FINISH SPECIFICATIONS SHALL BE BY THE ARCHITECT UNLESS OTHERWISE DESIGNATED IN THIS SPECIFICATION.
 - THE CONTRACTOR SHALL VERIFY THE CEILING CONSTRUCTION FOR EACH FIXTURE TYPE & LOCATION AND SHALL COORDINATE TRIM DETAILS
 - UNLESS OTHERWISE SPECIFIED, VOLTAGES OF ALL LAMPS SHALL BE DETERMINED BY THE ELECTRICAL ENGINEER. THE ELECTRICAL CONTRACTOR SHALL COORDINATE PROPER LAMP BASE TYPES WITH SOCKETS PROVIDED IN SPECIFIED FIXTURES
 - ALL FLUORESCENT LAMPS UNLESS NOTED OTHERWISE SHALL BE WARM WHITE IN COLOR RENDERING
 - ALL FLUORESCENT FIXTURES REQUIRING BALLASTS SHALL UNIVERSAL CT8A BALLASTS AS RECOMMENDED BY THE DIMMER MANUFACTURER LUTRON ELECTRONICS CO.

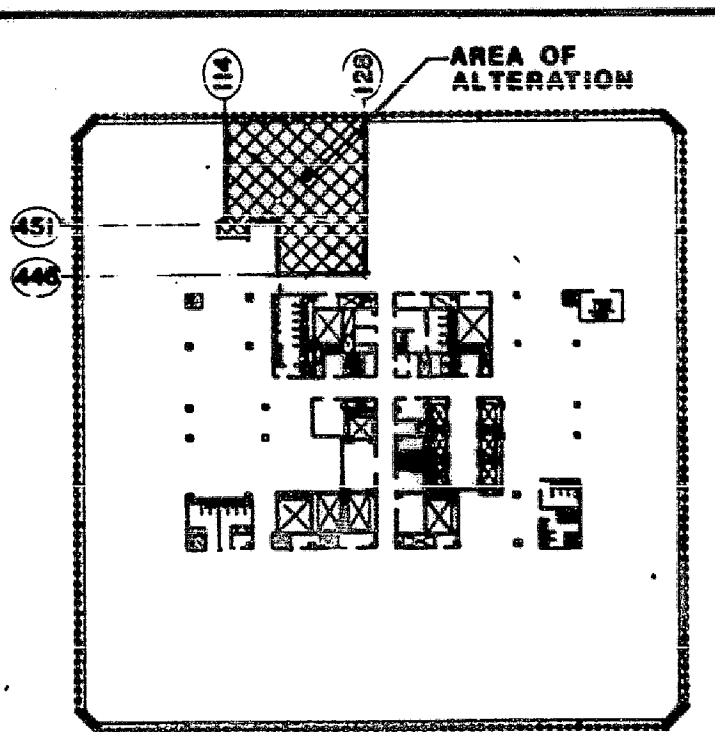

KEY PLAN
1/8" = 1'-0"

PHASE
P
TAA NO. 91051

**PROPOSED NEW TRADING ROOM
FOR INVESTMENT STRATEGIES**

REFLECTED CEILING PLAN

PROJECT NO. 706
SCALE 1/4" = 1'-0"
DRAWN BY J.R.P.
CHECKED BY J.R.P.
DATE MARCH 20, 1991

DRAWING NO. 105P

JUSTIN PC ARCHITECTS
205 LEXINGTON AVE
NEW YORK, NY 10018
TEL (212) 699 9550

JOHN C. WESTRICK & ASSOCIATES
CONSULTING ENGINEERS
2110 MAPLE AVE. SOUTH PLAINFIELD, N.J.
07080 201 581-5770

DATE	ISSUED TO	PR.	TR.
3/23/91	PORT AUTHORITY FOR APPROVAL	10	1
3/23/91	CFSC FOR RECORD	4	1
4/9/91	CONTRACTORS FOR BIDDING	1	1
4/9/91	CFSC	1	1
5-8-91	P.A. FOR APPROVAL	10	-
5-22-91	C.D.S. MESTAL	5	3
6-7-91	CFSC	1	1
10-21-91	P.A. AS BUILT DRAWING	-	1

AS BUILT DRAWING
Date 8-6-91
JUSTIN PC ARCHITECTS

8-6-91	REVISED TO SHOW AS BUILT CONDITIONS	JPP
NO DATE	REVISION	BY

**CANTOR, FITZGERALD
SECURITIES CORP.**
105TH FLOOR
ONE WORLD TRADE CENTER, NEW YORK, N.Y.

**PROPOSED NEW TRADING ROOM
FOR INVESTMENT STRATEGIES**

REFLECTED CEILING PLAN

PROJECT NO. 706
SCALE 1/4" = 1'-0"
DRAWN BY J.R.P.
CHECKED BY J.R.P.
DATE MARCH 20, 1991

DRAWING NO. 105P